


FOR COORDINATION  
NOTE: JCC is creating this drawing. JCC relied upon CAD and other data files furnished to us by others. JCC shall not be responsible for errors or omissions in such data files which may occur as the project progresses. Each contractor adding their systems or information to this drawing must independently confirm all data shown, including all dimensions, ceiling heights, and existing conditions.

**Cannistraro**  
AS-BUILT DRAWING  
DATE: 07/18/2016

# Homewood Suites

111 Boylston Street Brookline, MA

 
PL.00.1



# Homewood Suites

111 Boylston Street Brookline, MA

111 Boylston Street Brookline, MA

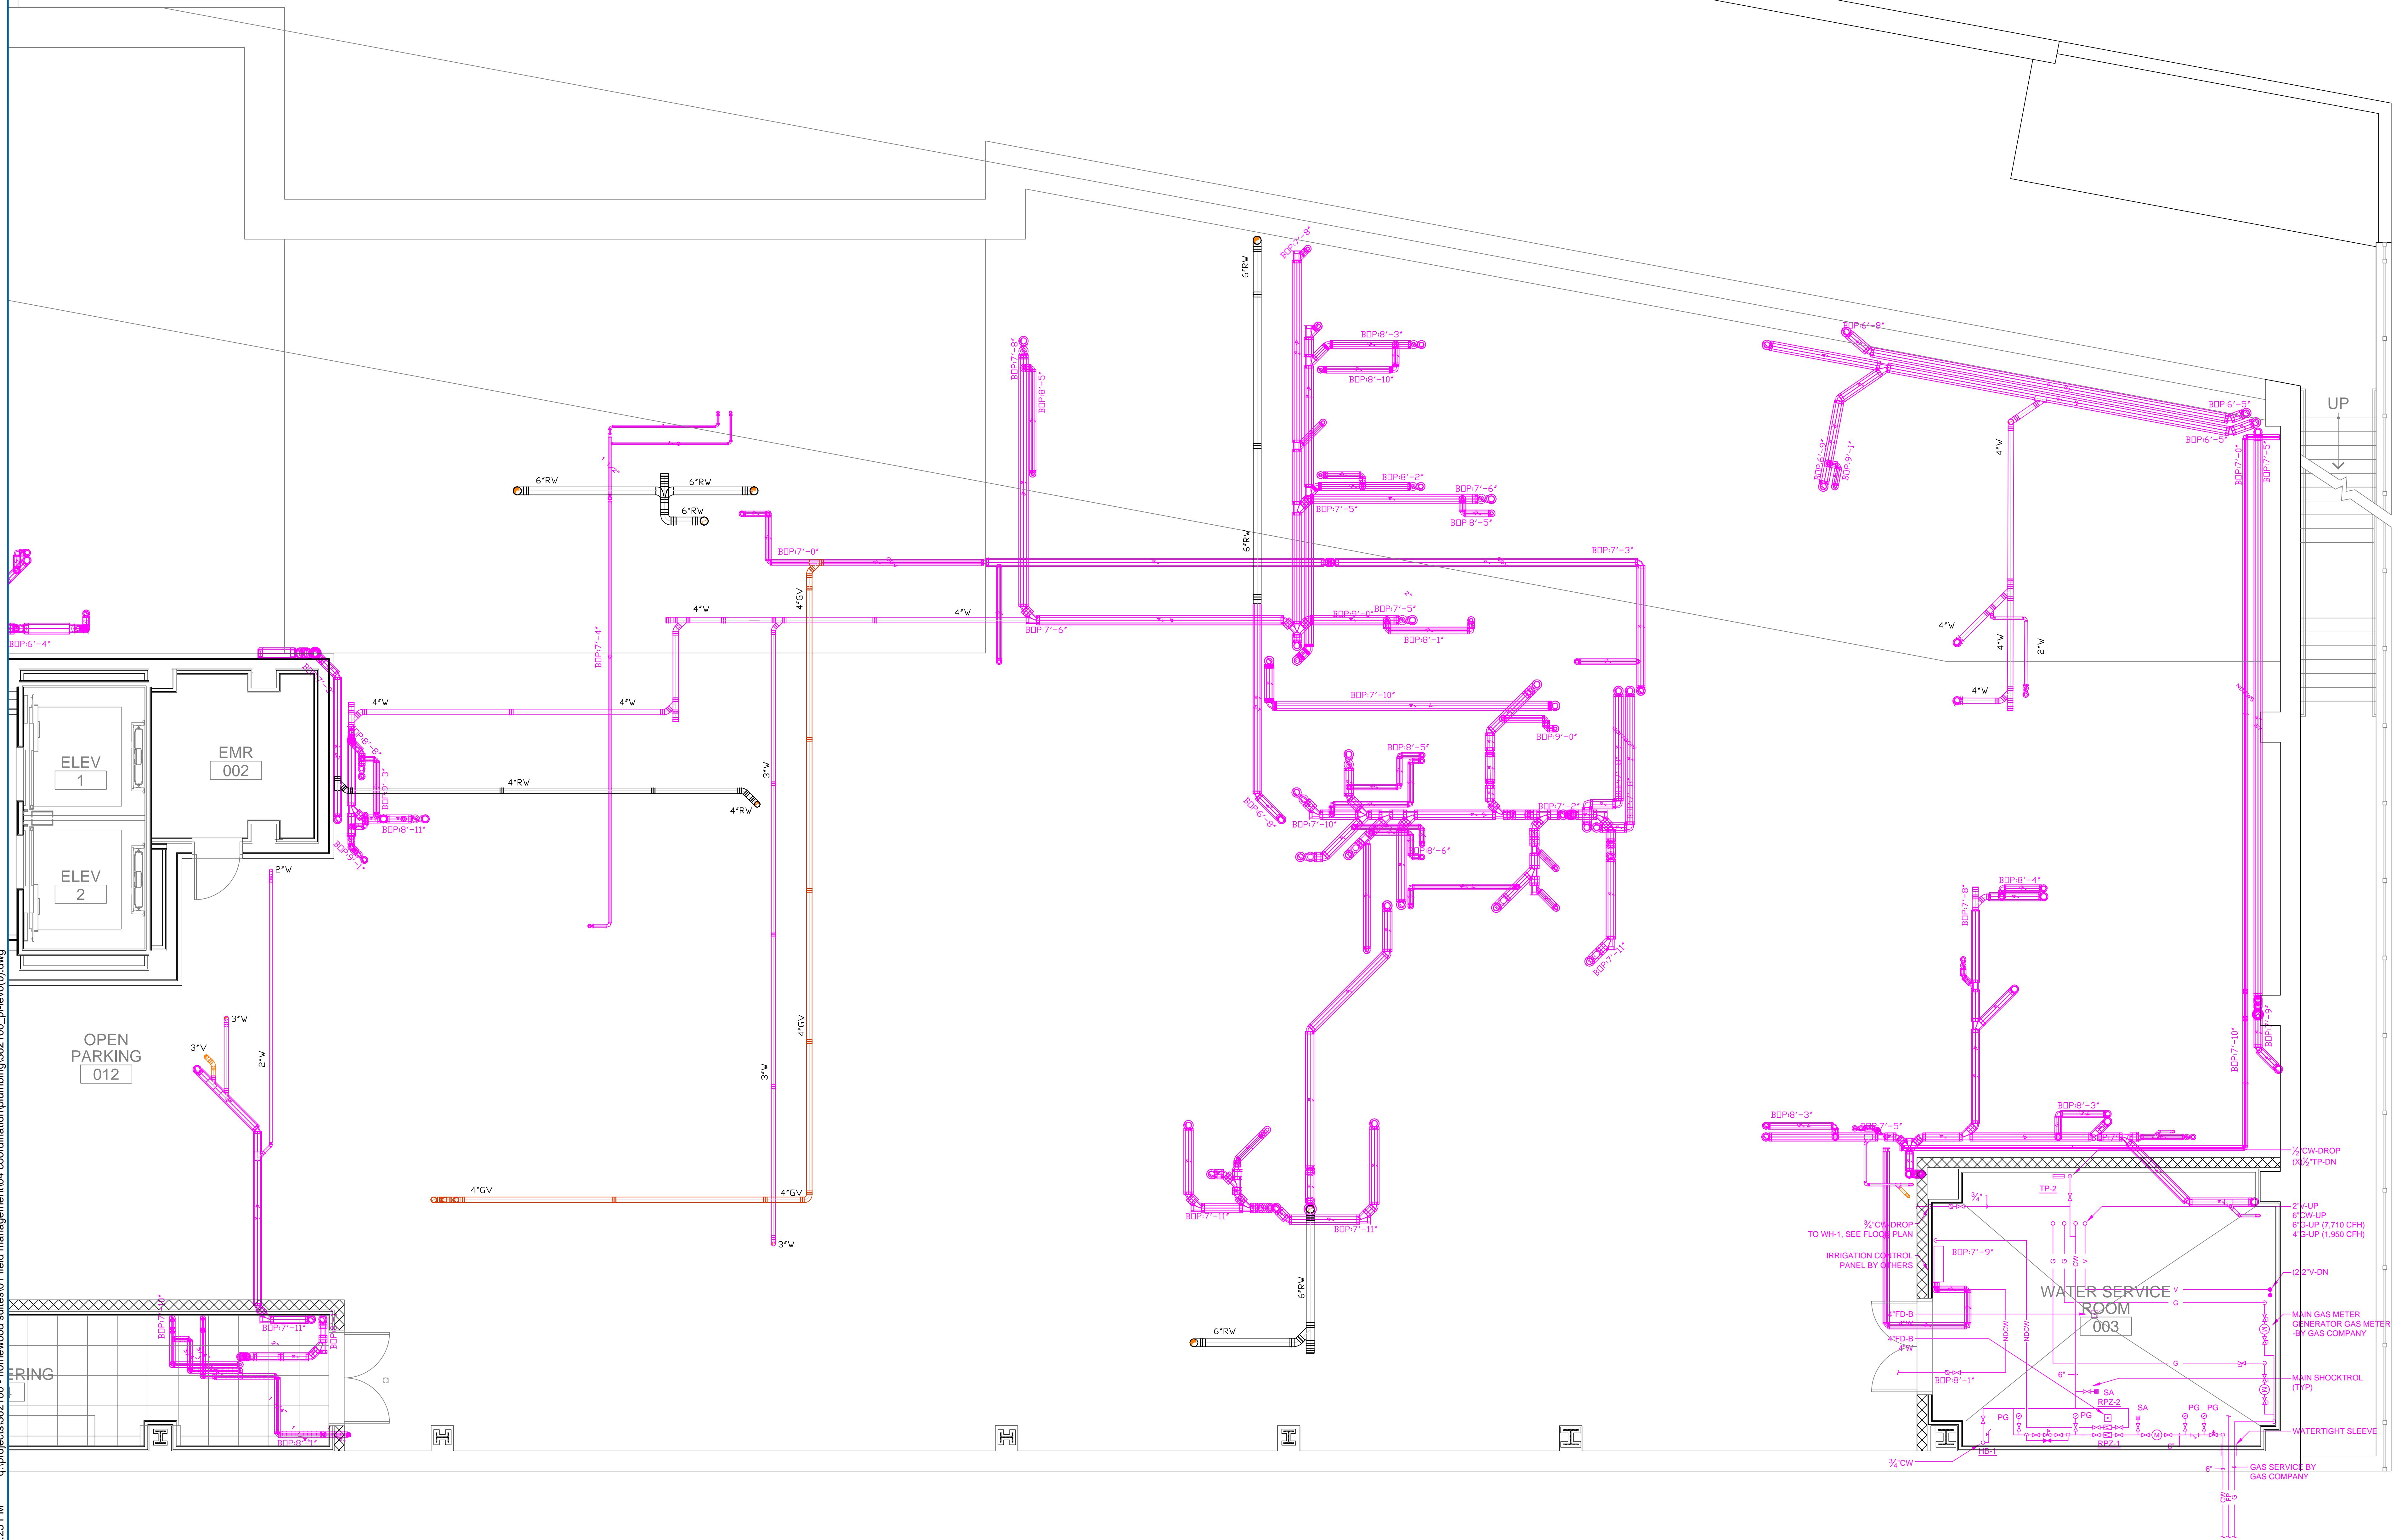

Number: 36  
checked by: 1/4":  
7/15


**PL.00.2**

FOR COORDINATION  
 NOTE: JCC relied upon CAD and other files furnished to us by others. JCC shall not be responsible for the errors or omissions which may occur as the project progresses. Each contractor adding their systems or information to this drawing must independently confirm all data shown, including all dimensions, ceiling heights, and existing conditions.

**Cannistraro**  
 AS-BUILT DRAWING  
 DATE: 07/18/2016

## Homewood Suites

 
111 Boylston Street, Brookline, MA



# Homewood Suites

111 Boylston Street, Brookline, MA

 111 Boylston Street, Brookline, MA



Key Plan:	
Project Number:	362100
Drawn/Checked by:	--
Scale:	1/4"=1'-0"
Date:	7/18/2016
Issue:	
Plumbing-Coordination	
LEVEL 01	

# PL.01.2

FOR COORDINATION  
 NOTE: JCC relied upon CAD and other files furnished to us by others. JCC shall not be responsible for errors or omissions which may occur as the project progresses. Each contractor adding their systems or information to this drawing must independently confirm all data shown, including all dimensions, ceiling heights, and existing conditions.

**Cannistraro**  
 AS-BUILT DRAWING  
 DATE: 07/18/2016

## Homewood Suites

111 Boylston Street Brookline, MA




FOR COORDINATION  
NOTE: JCC is creating this drawing JCC relied upon CAD and other DWG files furnished to us by others. JCC shall not be responsible for the errors or omissions in such drawings which may occur as the project progresses. Each contractor adding their systems or information to this drawing must independently confirm all dimensions shown, including all dimensions, ceiling heights, and existing conditions.

**Cannistraro**  
AS-BUILT DRAWING  
DATE: 07/18/2016

# Homewood Suites

111 Boylston Street Brookline, MA

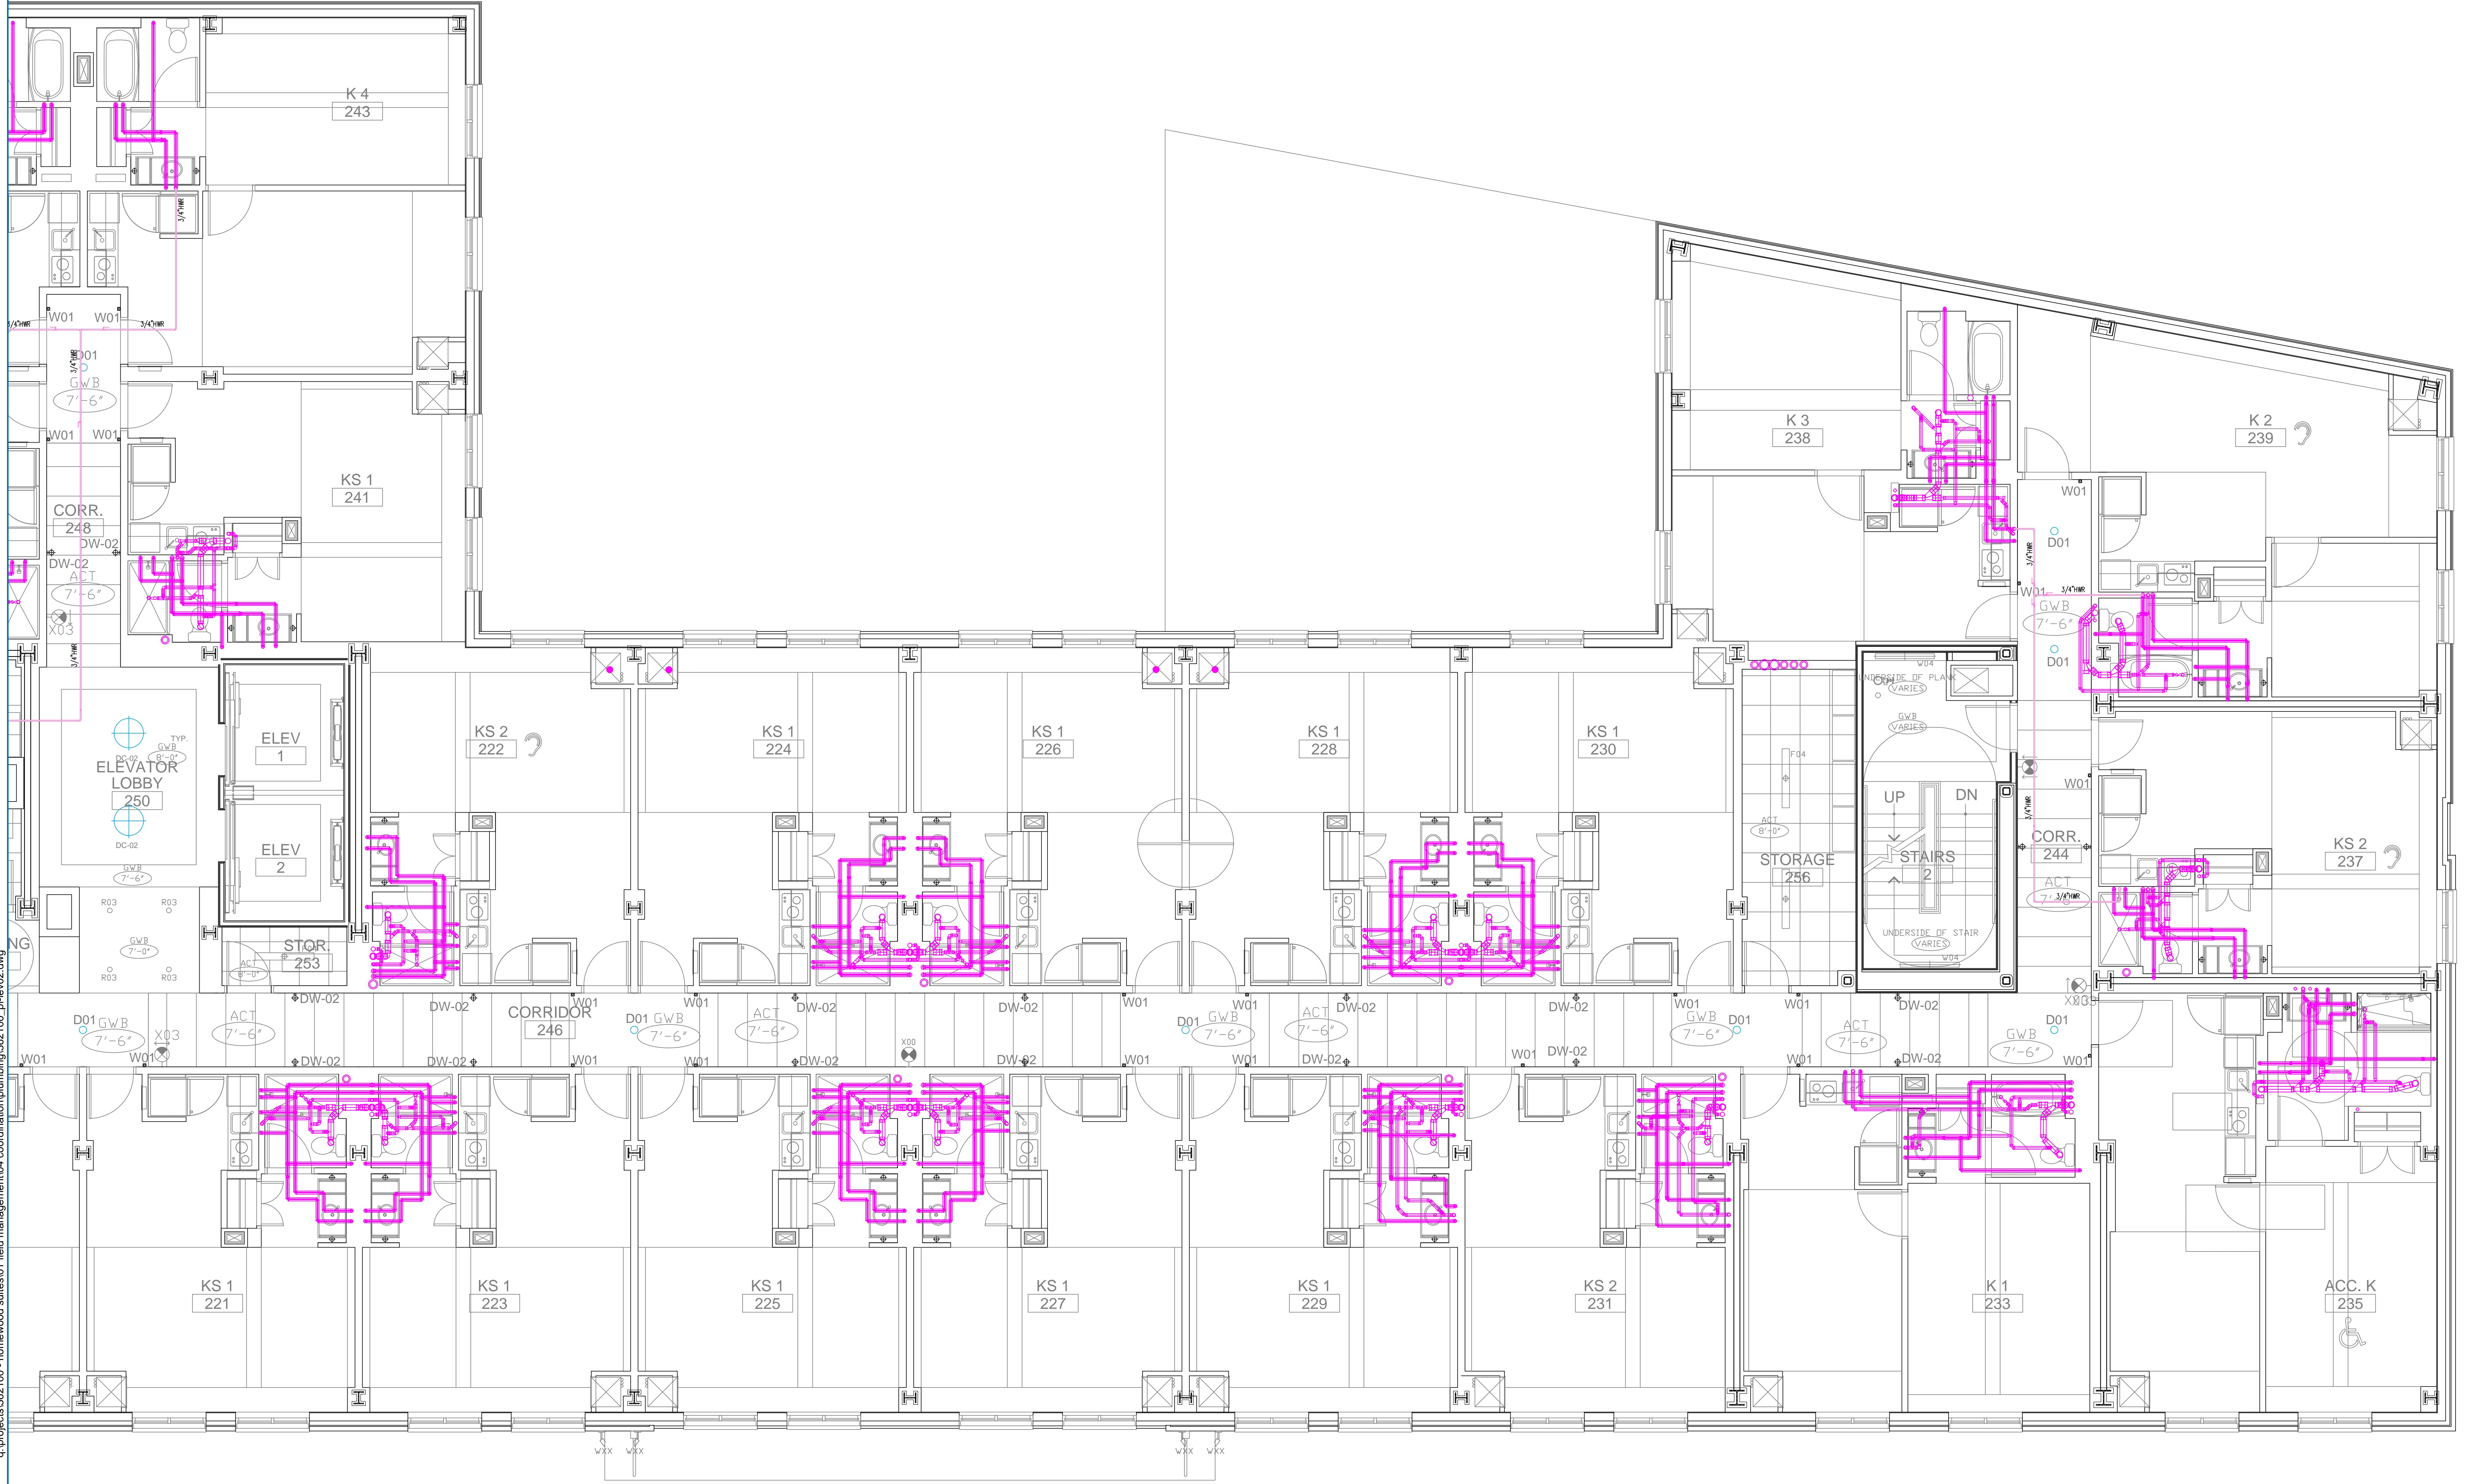

Key Plan:  
Project Number: 362100  
Drawn/Checked by: ---  
Scale: 1/4"=1'-0"  
Date: 7/18/2016  
Issue: -  
Plumbing-Coordination  
LEVEL 02

FOR COORDINATION  
NOTE: JCC is creating this drawing. JCC relied upon CAD and other data files furnished to us by others. JCC shall not be responsible for errors or omissions in such data files which may occur as the project progresses. Each contractor adding their systems or information to this drawing must independently confirm all data shown, including all dimensions, ceiling heights, and existing conditions.

**Cannistraro**  
AS-BUILT DRAWING  
DATE: 07/18/2016

# Homewood Suites

111 Boylston Street, Brookline, MA




Key Plan:  
Project Number: 362100  
Drawn/Checked by: ---  
Scale: 1/4"=1'-0"  
Date: 7/18/2016  
Issue: -  
Plumbing-Coordination  
LEVEL 03





# Homewood Suites

111 Boylston Street, Brookline, MA

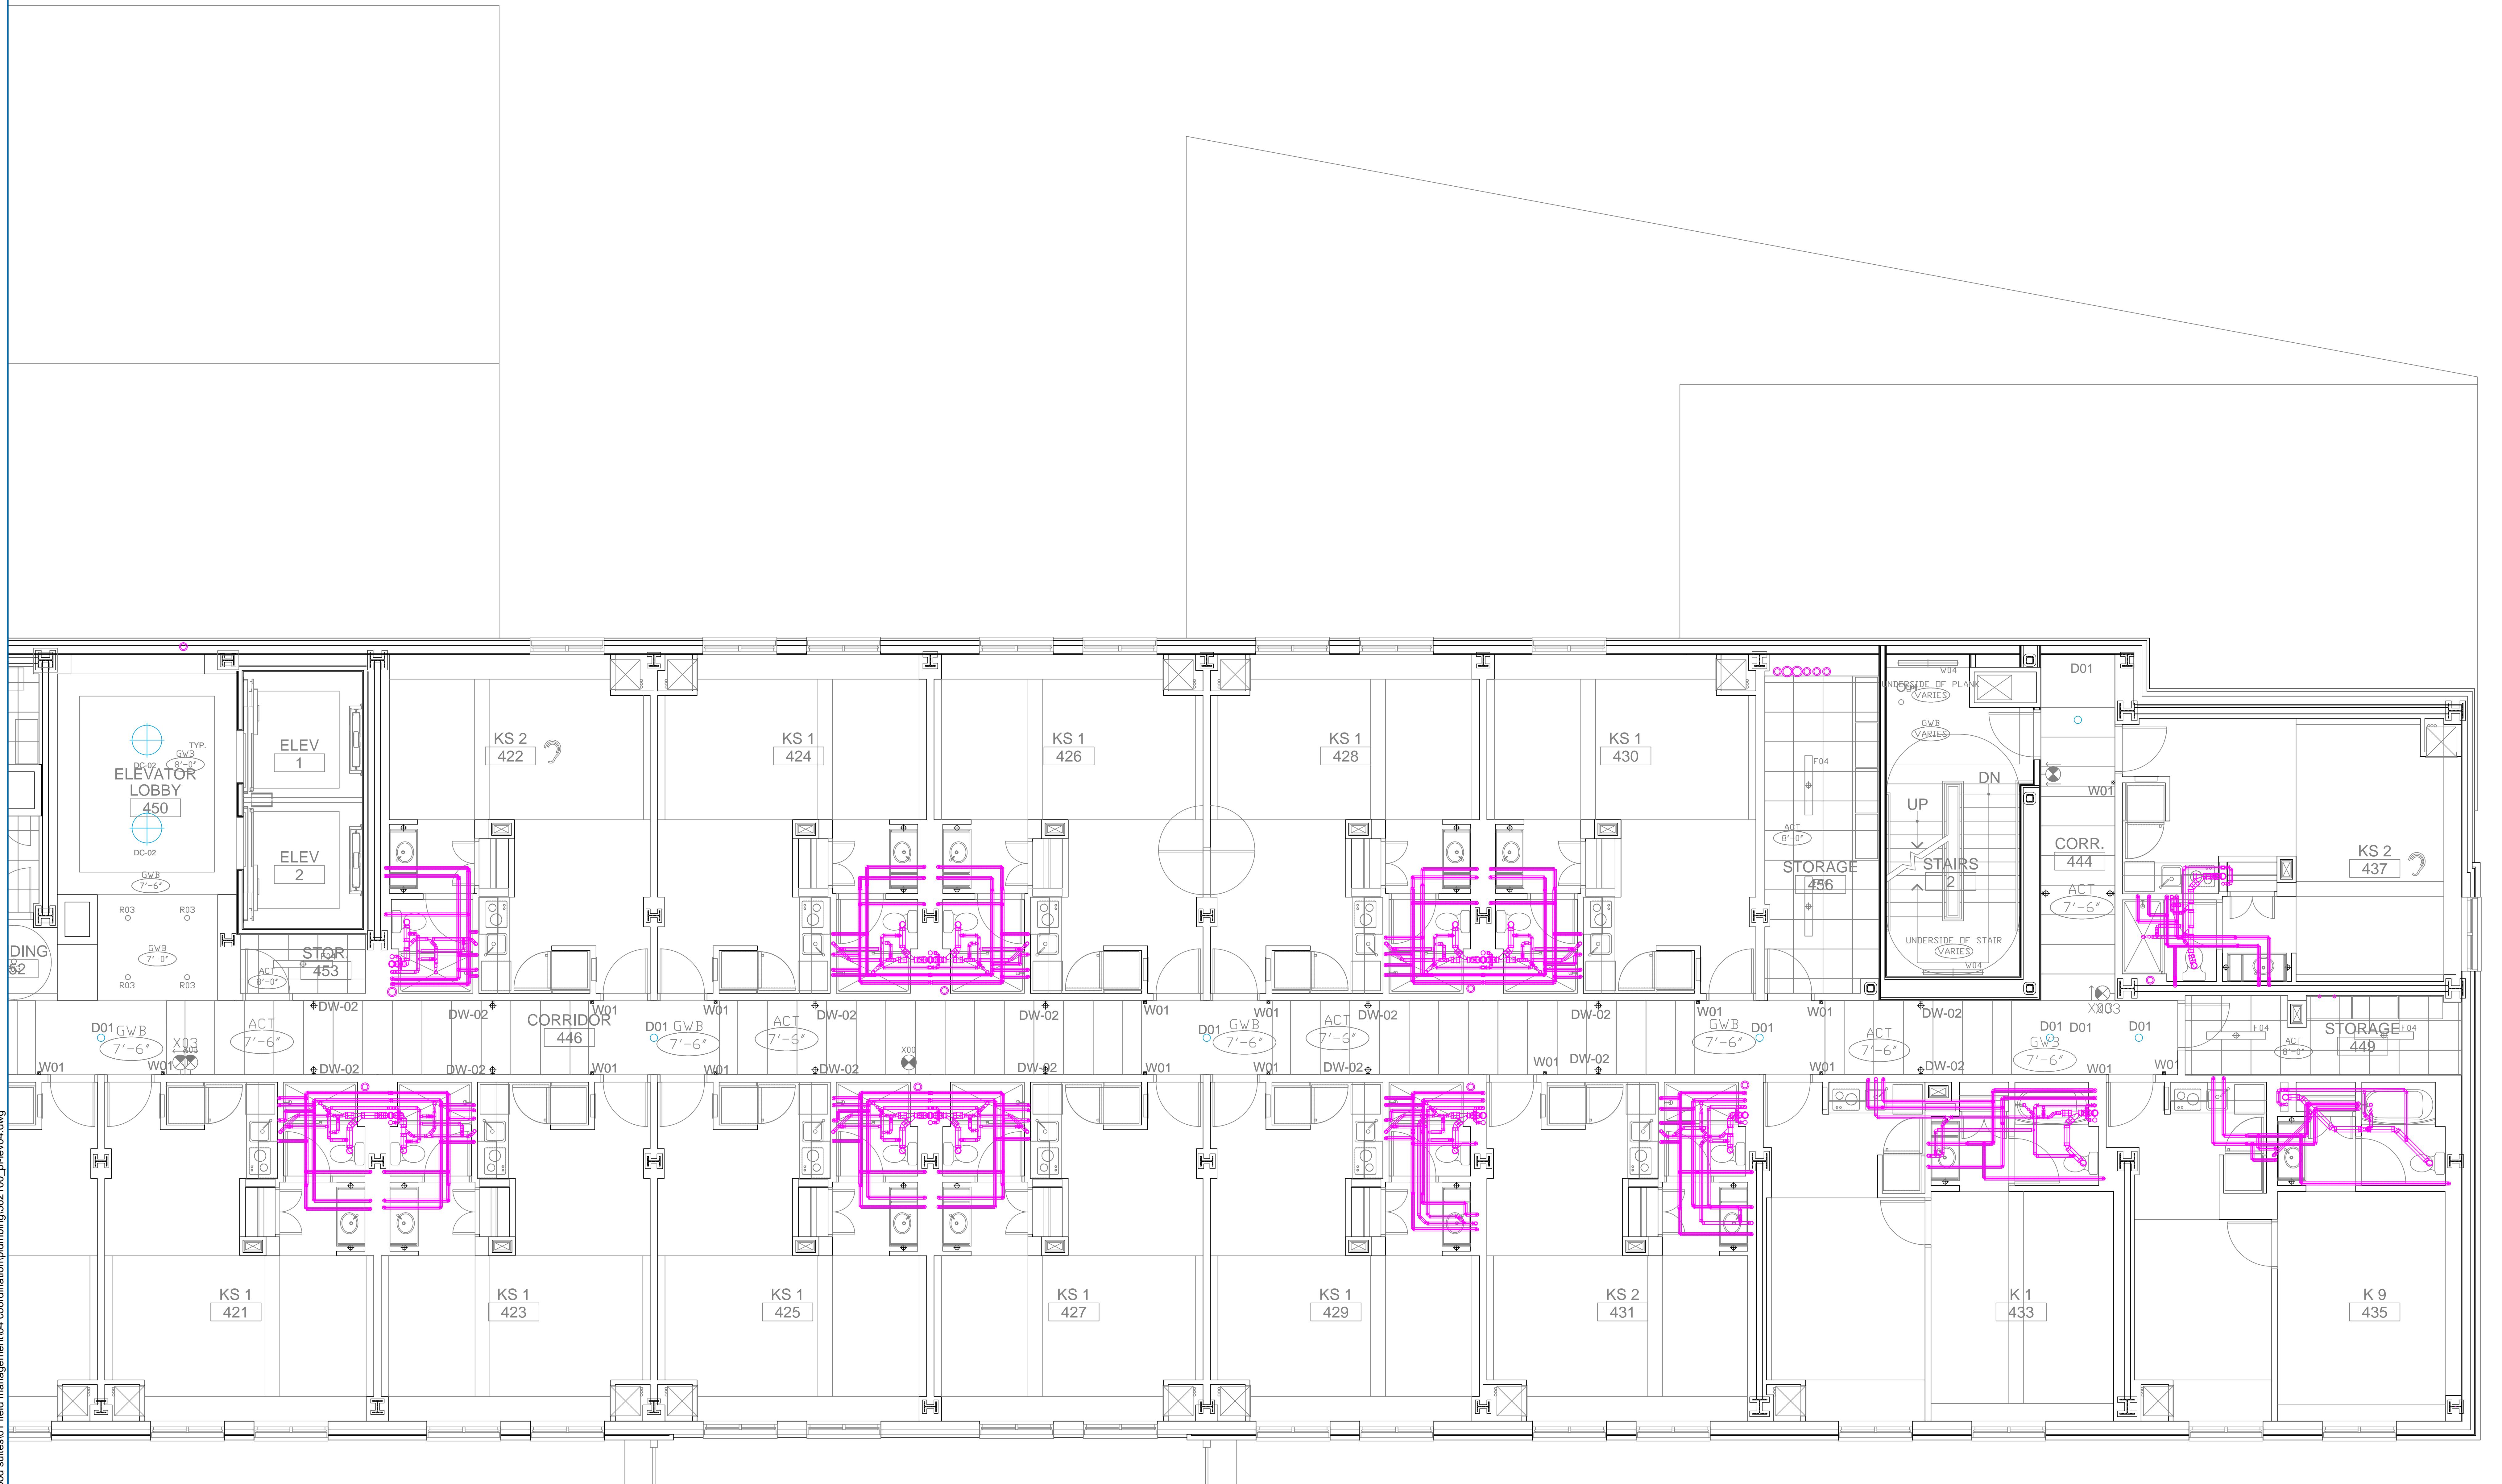


Key Plan:  
 Project Number: 362100  
 Drawn/Checked by: ---  
 Scale: 1/4"=1'-0"  
 Date: 7/18/2016  
 Issue: -  
 Plumbing-Coordination  
 LEVEL 04

PL.04.2

# Homewood Suites


111 Boylston Street, Brookline, MA

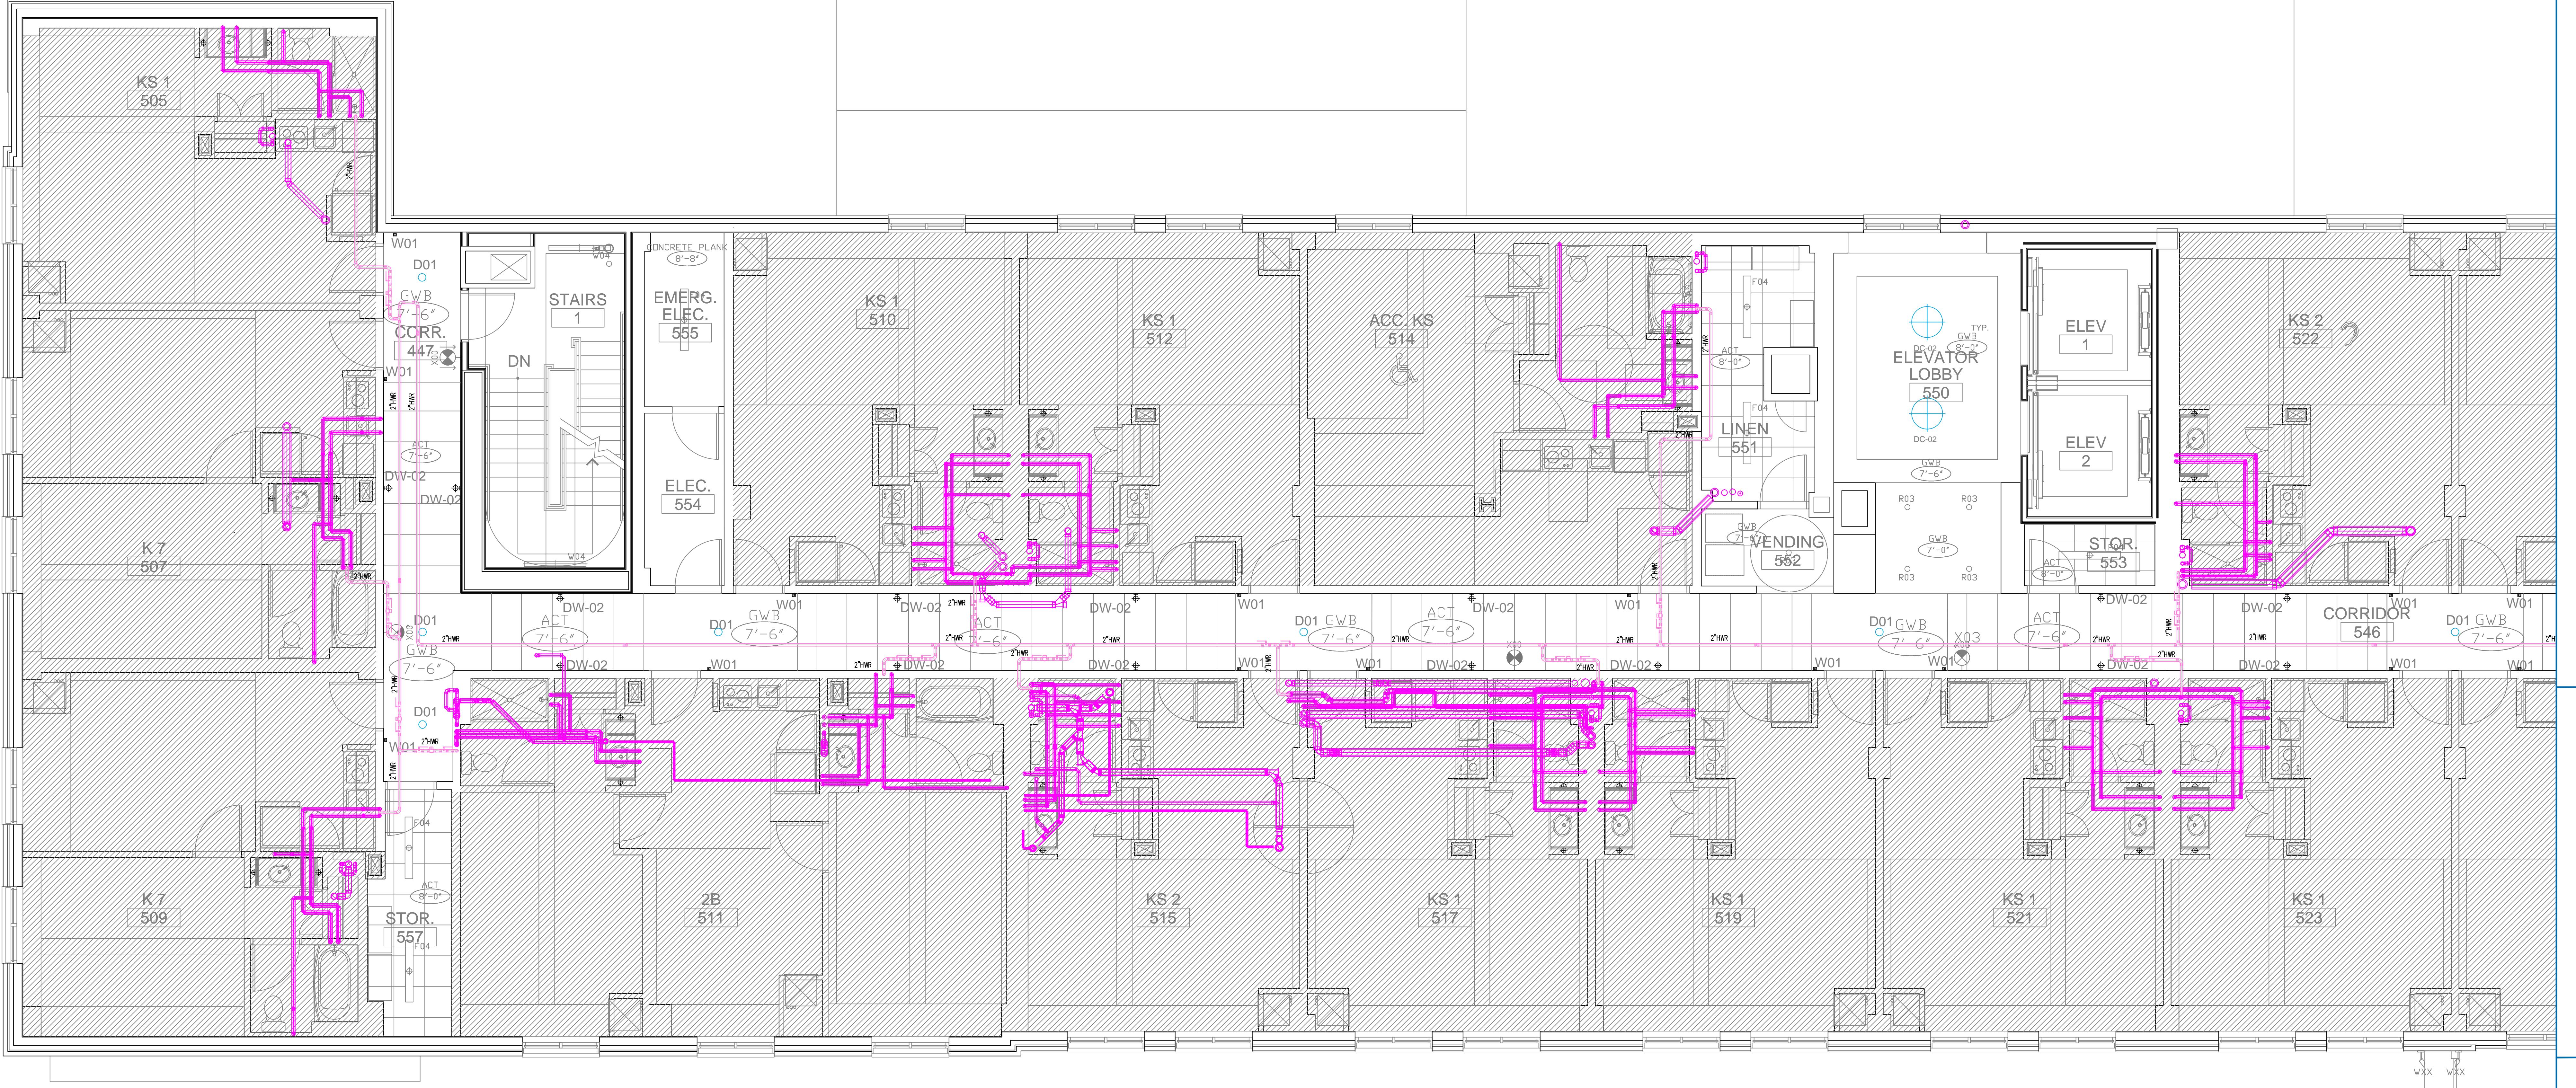

Key Plan:  
 Project Number: 362100  
 Drawn/Checked by: ---  
 Scale: 1/4"=1'-0"  
 Date: 7/18/2016  
 Issue: -  
 Plumbing-Coordination  
 LEVEL 05

# Homewood Suites

111 Boylston Street, Brookline, MA

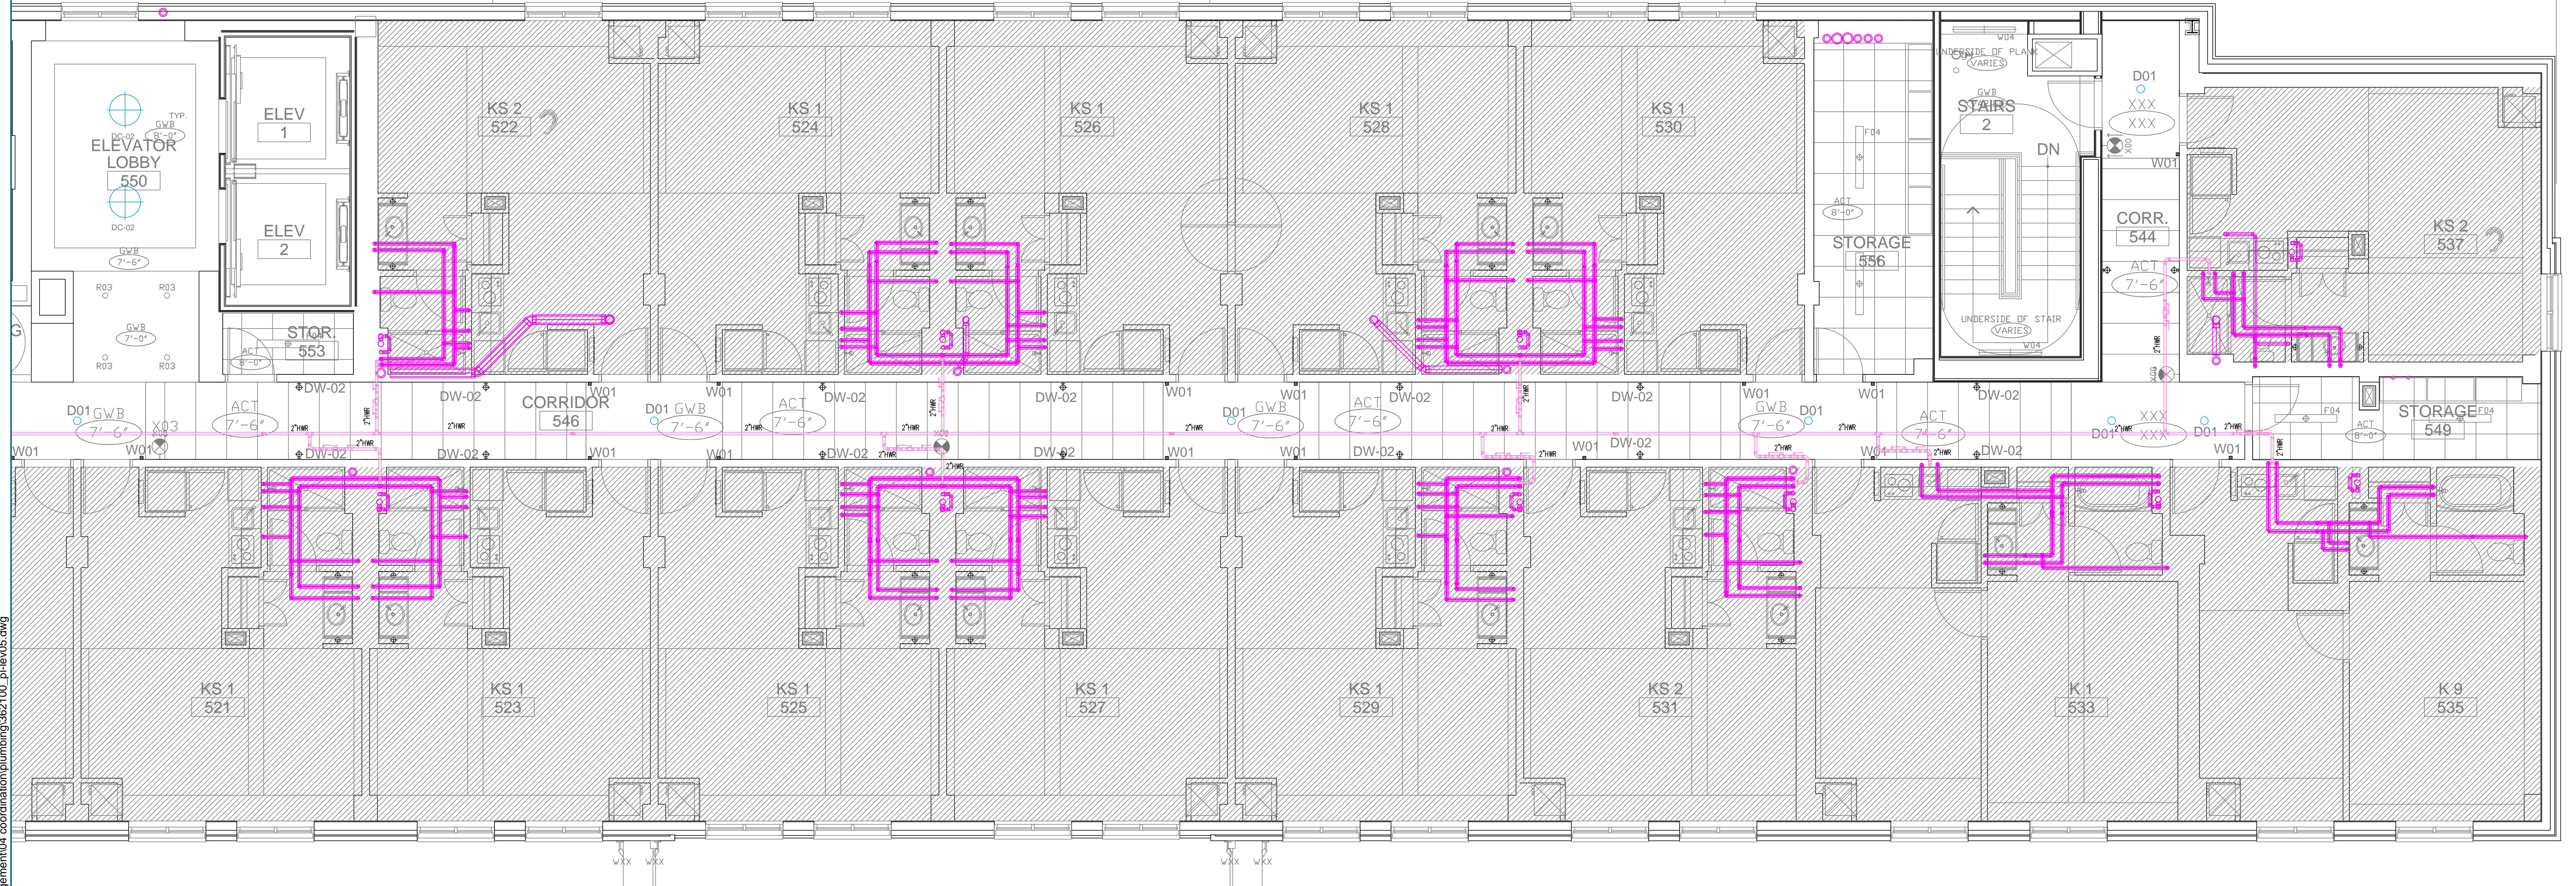

Key Plan:  
 Project Number: 362100  
 Drawn/Checked by: ---  
 Scale: 1/4"=1'-0"  
 Date: 7/18/2016  
 Issue: -  
 Plumbing-Coordination  
 LEVEL 05

PL.05.2

FOR COORDINATION  
NOTE: JCC, in creating this drawing JCC relied upon CAD and other data files furnished to us by others. JCC shall not be responsible for any errors or omissions in such data which may occur as the project progresses. Each contractor adding their systems or information to this drawing must independently confirm all data shown, including all dimensions, ceiling heights, and existing conditions.

## Homewood Suites

111 Boylston Street, Brookline, MA

